



[www.autodesk.com/revit](http://www.autodesk.com/revit)

Consultant  
Address  
Address  
Phone  
Fax  
e-mail

Consultant  
Address  
Address  
Phone  
Fax  
e-mail

Consultant  
Address  
Address  
Phone  
Fax  
e-mail

Consultant  
Address  
Address  
Phone  
Fax  
e-mail

[illegible]

Autodesk  
Sample House

## Plans

Project number	001-00
----------------	--------

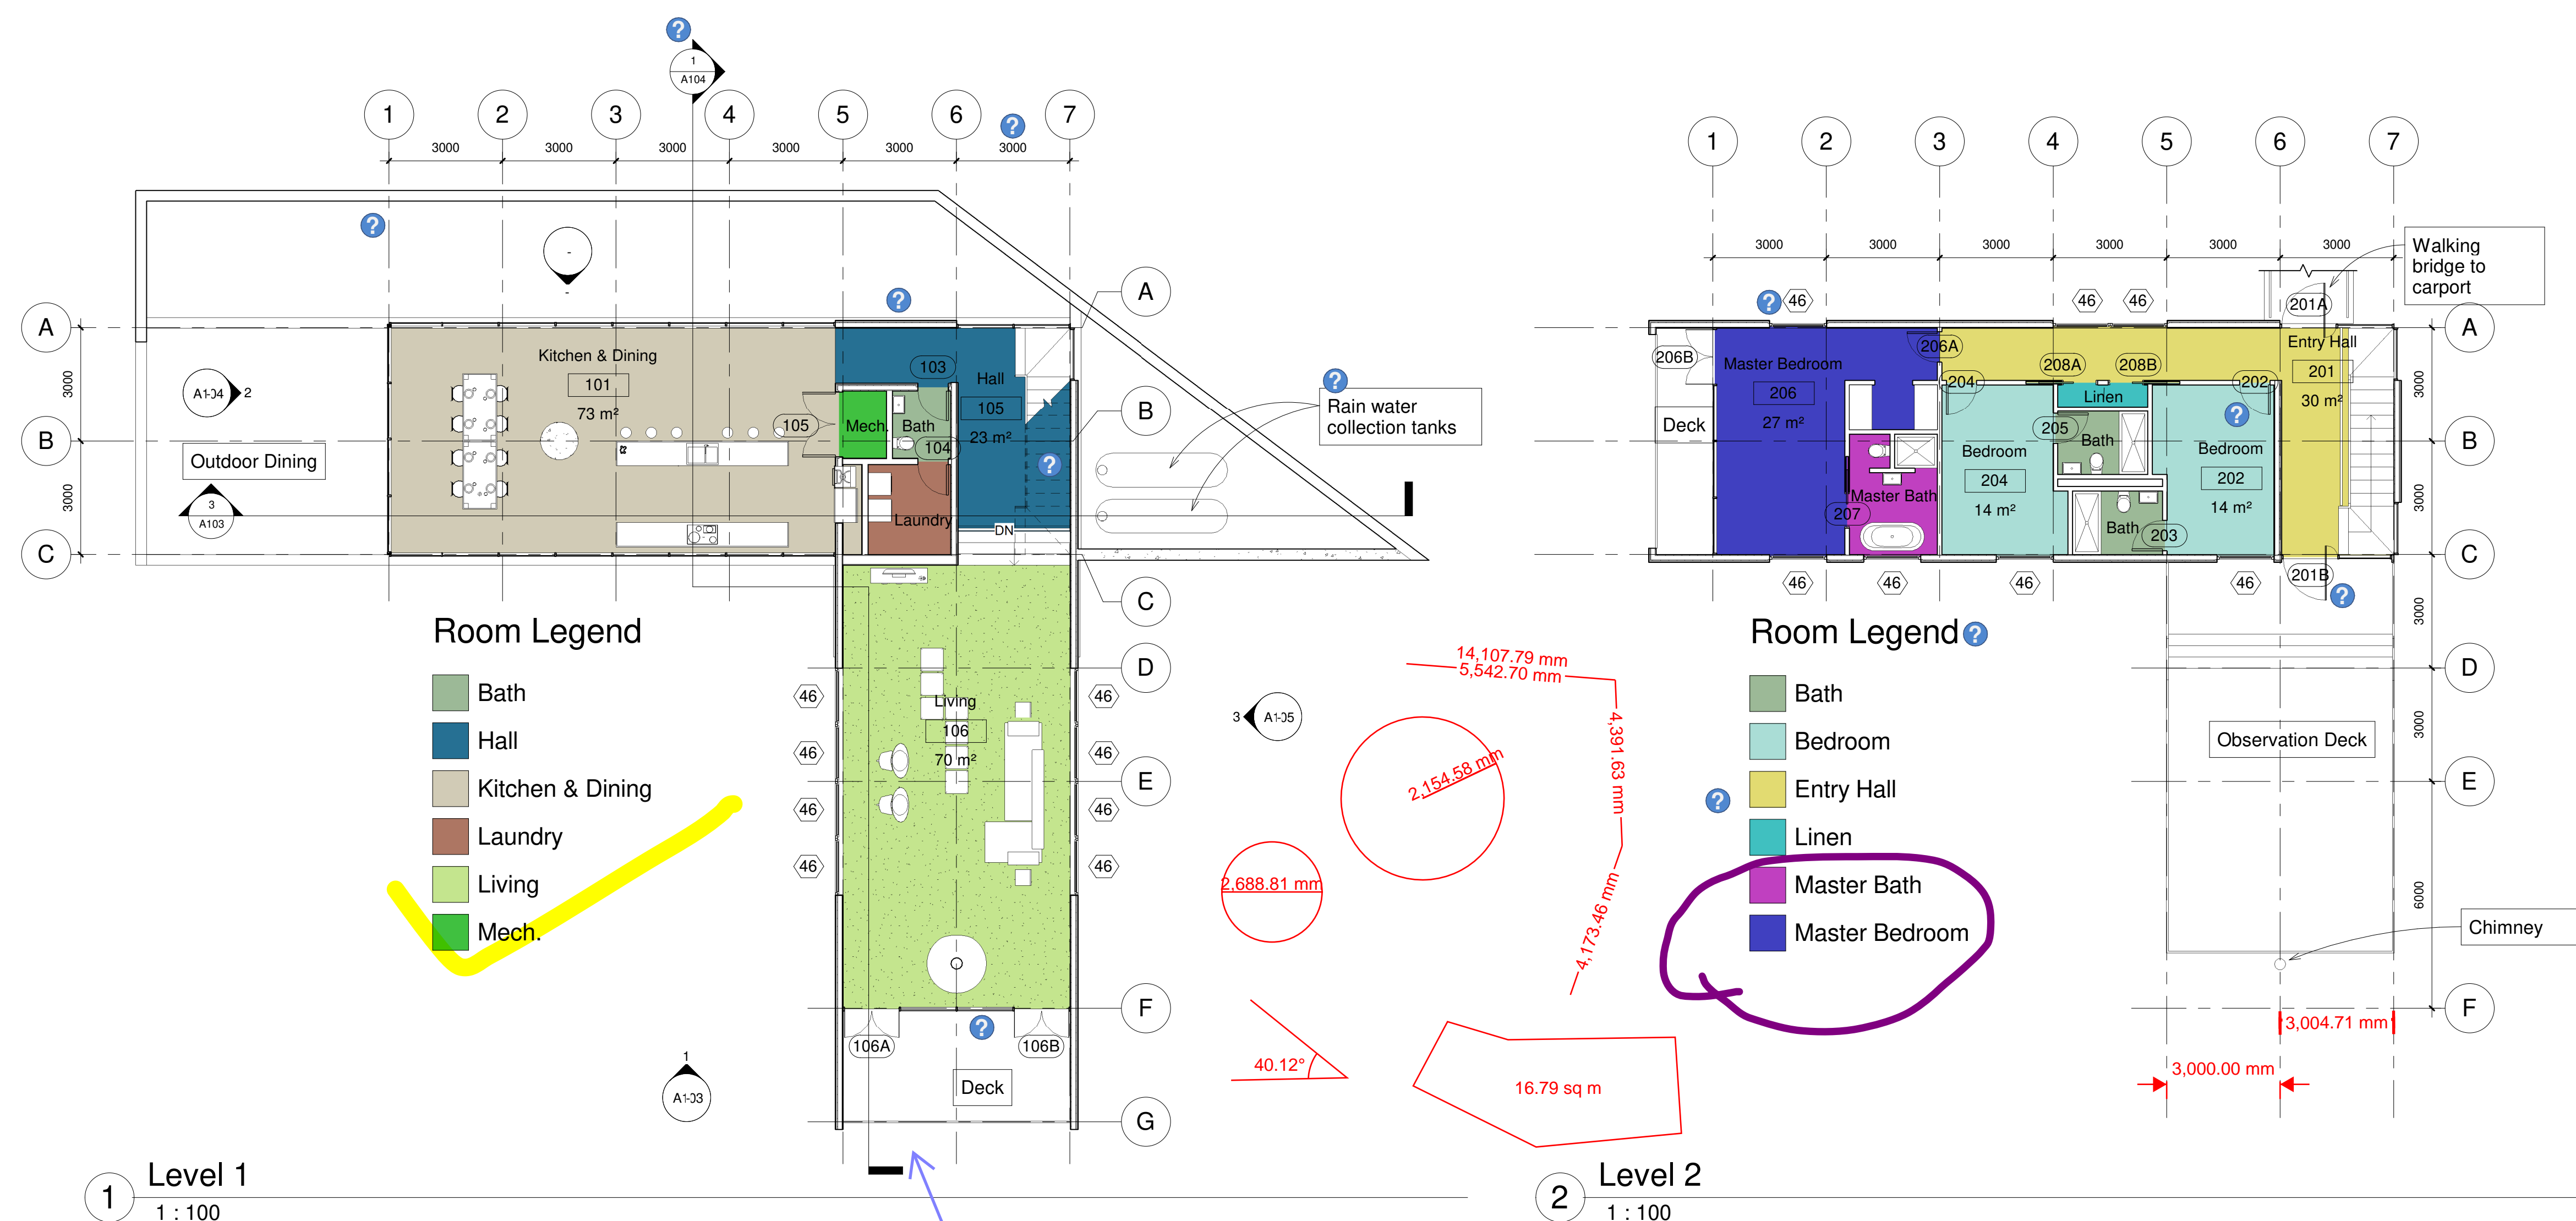
Date	Issue Date
------	------------

Drawn by	SM
----------	----

Checked by	JLH
------------	-----

A102

Scale	1 : 100
-------	---------

[illegible]

**APPROVED**

Revision cloud  
with label

Little mark-up text here

Call out with Leader

