



www.autodesk.com/revit

Consultant
Address
Address
Phone
Fax
e-mail

Consultant
Address
Address
Phone
Fax
e-mail

Consultant
Address
Address
Phone
Fax
e-mail

Consultant
Address
Address
Phone
Fax
e-mail

[illegible]

Autodesk

Sample House

Plans

Project number	001-00
----------------	--------

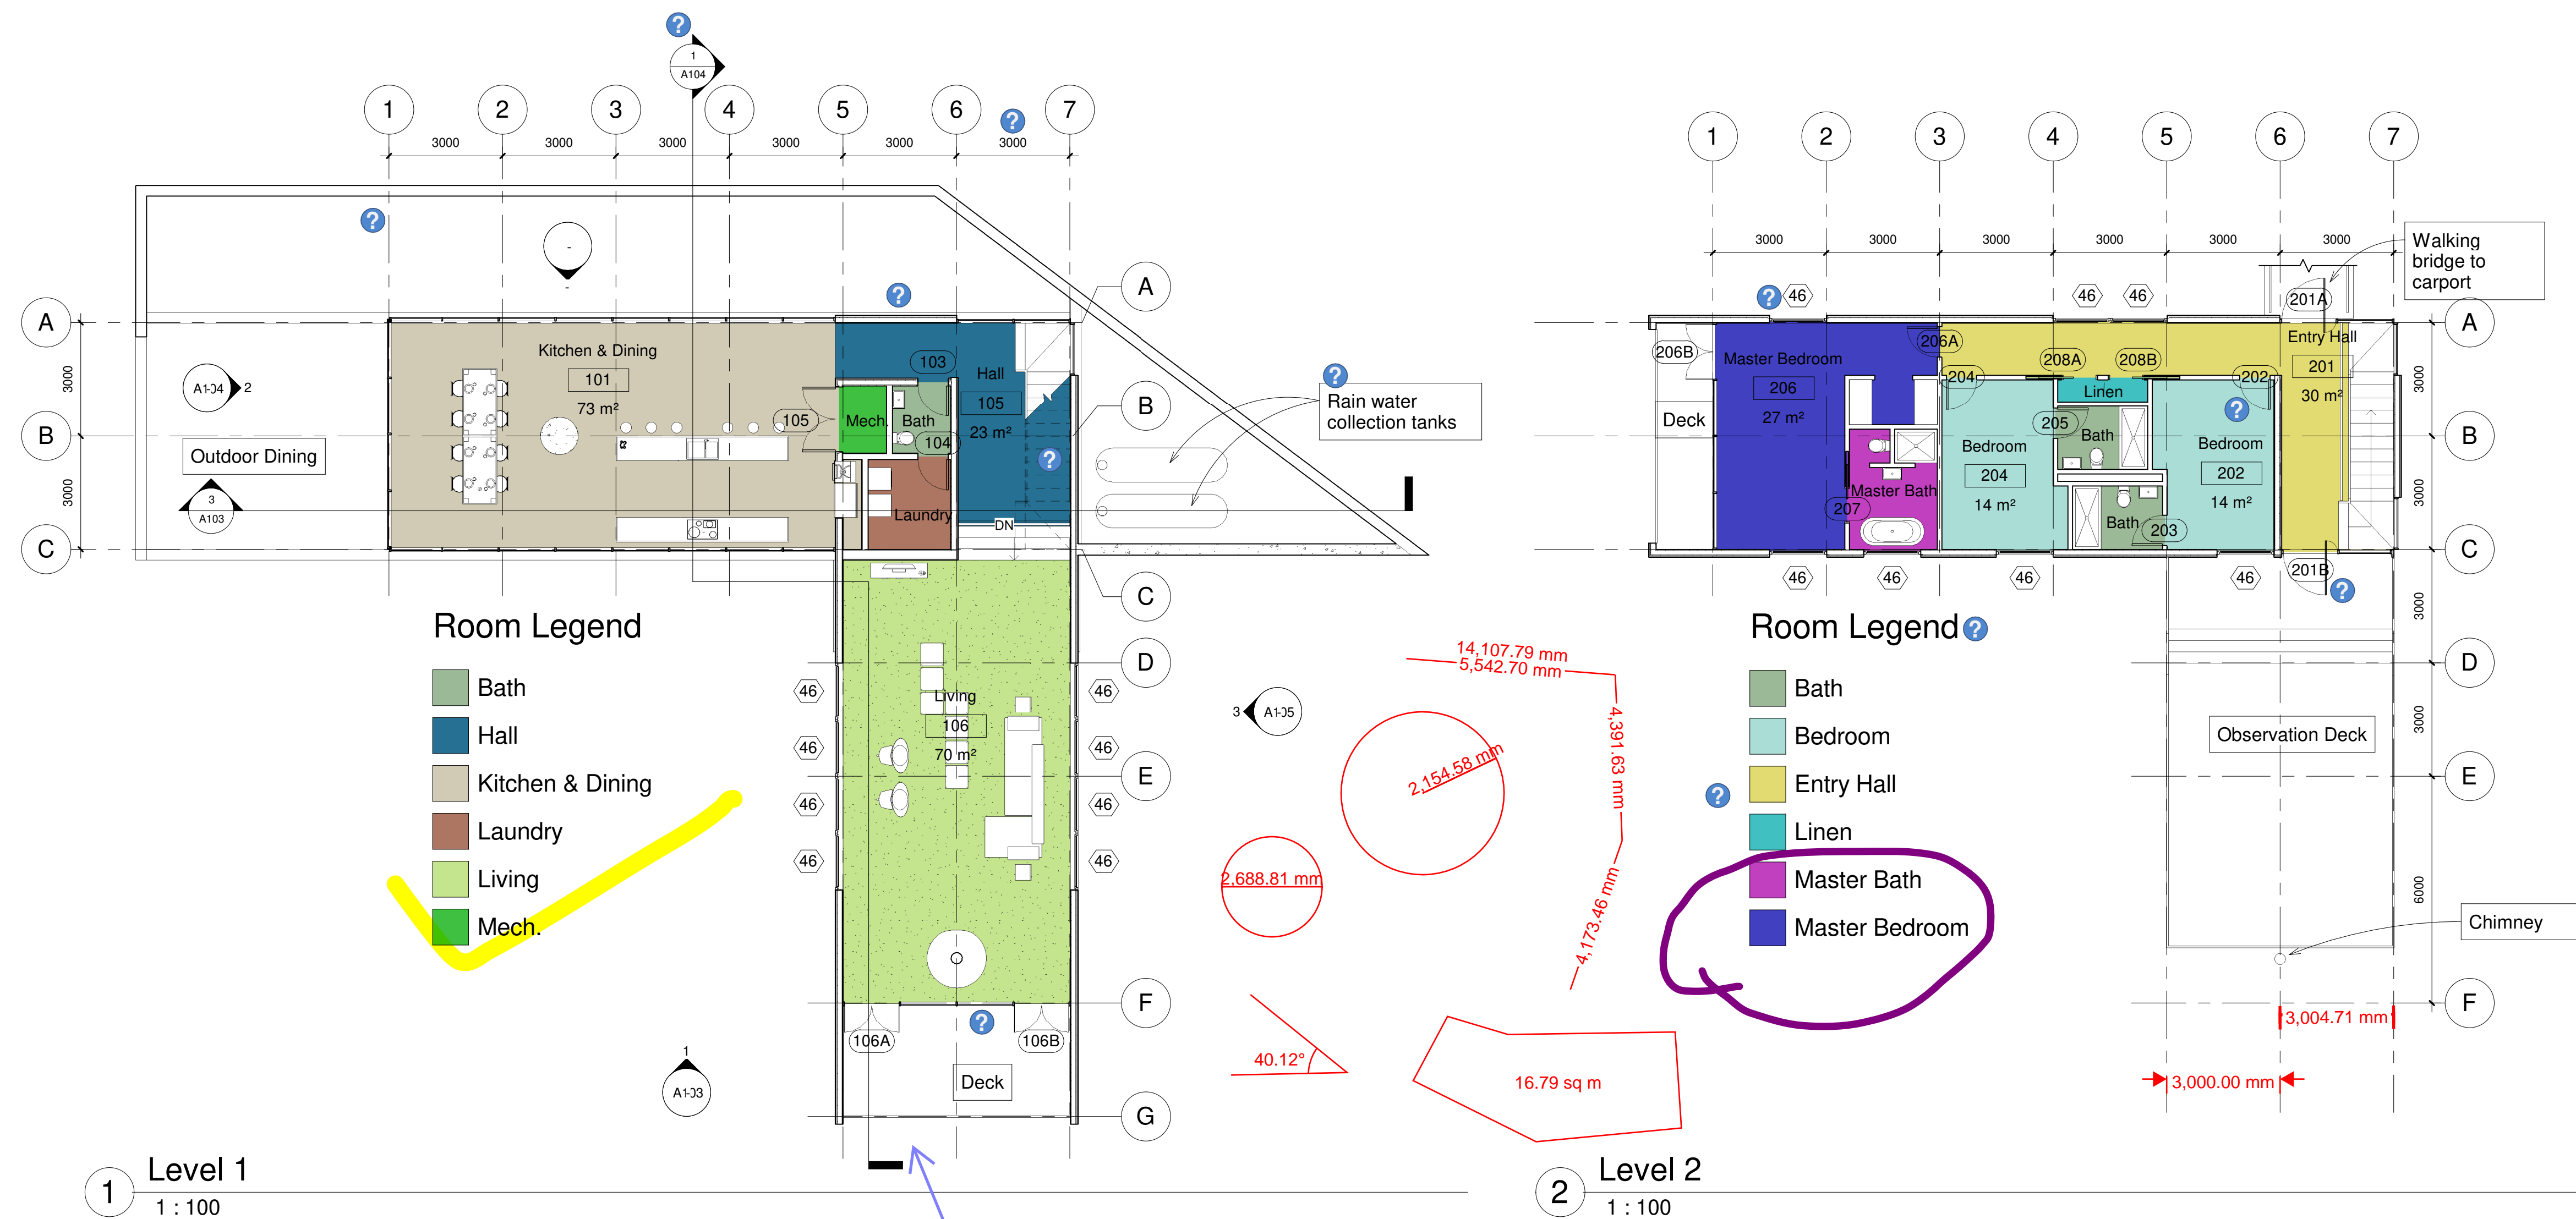
Date	Issue Date
------	------------

Drawn by	SM
----------	----

Checked by	JLH
------------	-----

A102

Scale 1 : 100

[illegible]

APPROVED

Revision cloud
with label

Little mark-up text here

Call out with Leader

hatever: