



Consultant
Address
Address
Phone
Fax
e-mail

Consultant
Address
Address
Phone
Fax
e-mail

Consultant
Address
Address
Phone
Fax
e-mail

Consultant
Address
Address
Phone
Fax
e-mail

[illegible]

Autodesk
Sample House

Plans

Project number	001-00
----------------	--------


Date	Issue Date
------	------------

Drawn by	SM
----------	----

Checked by	JLH
------------	-----

A102

Scale	1 : 100
-------	---------

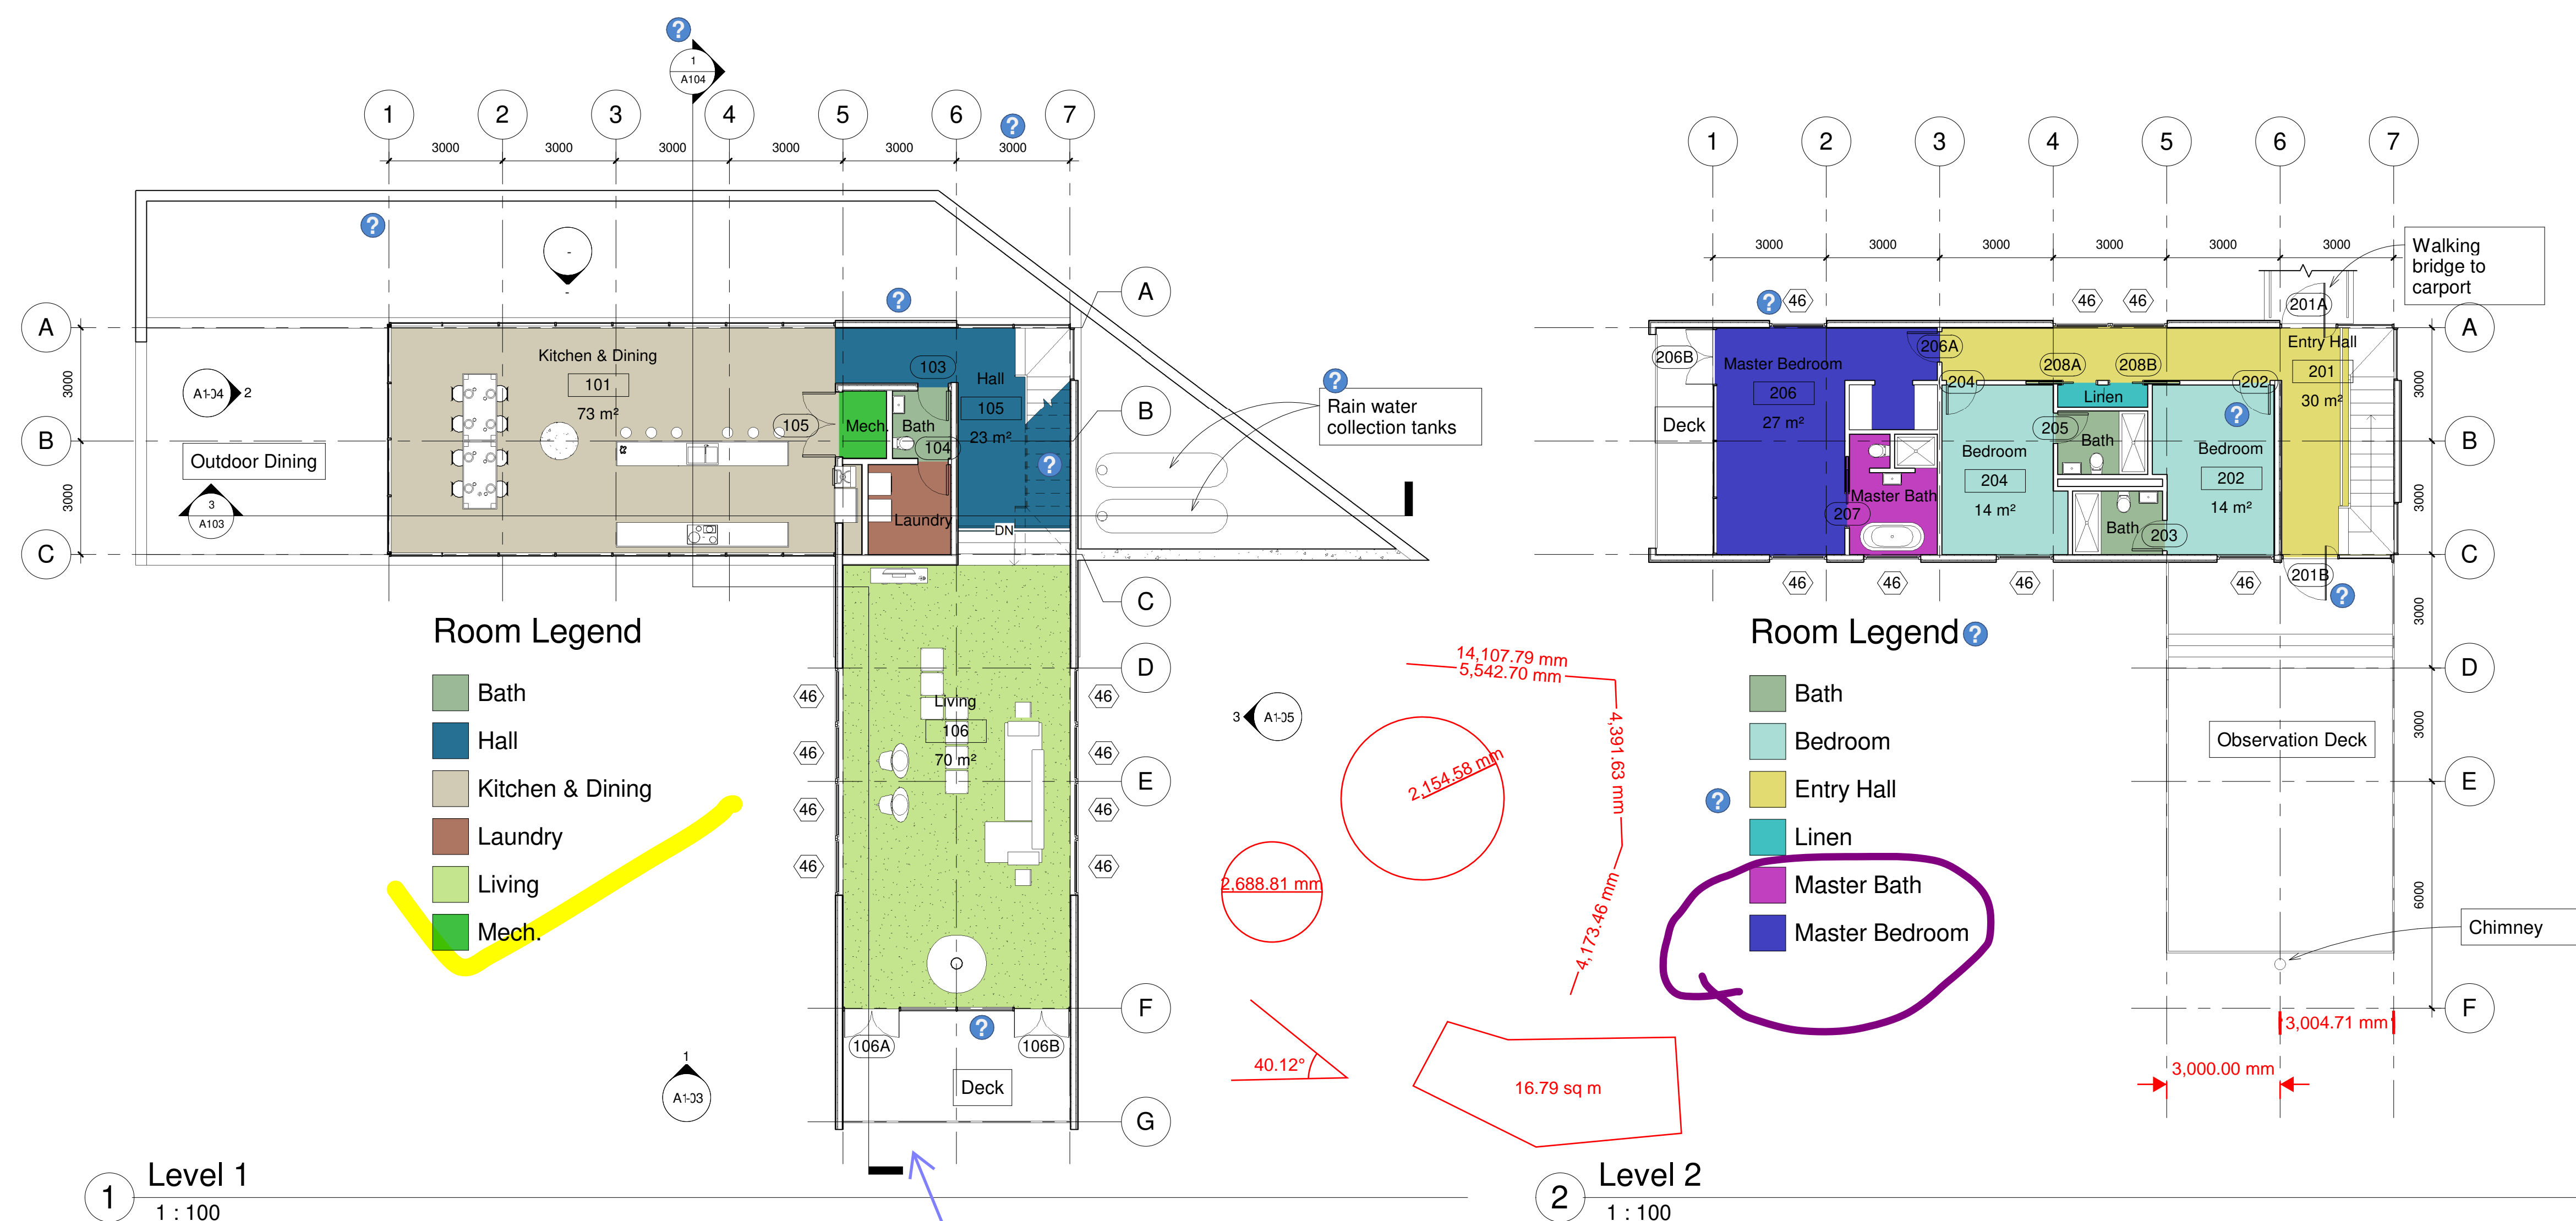

APPROVED

Little mark-up text here

Call out with Leader

Revision cloud
with label